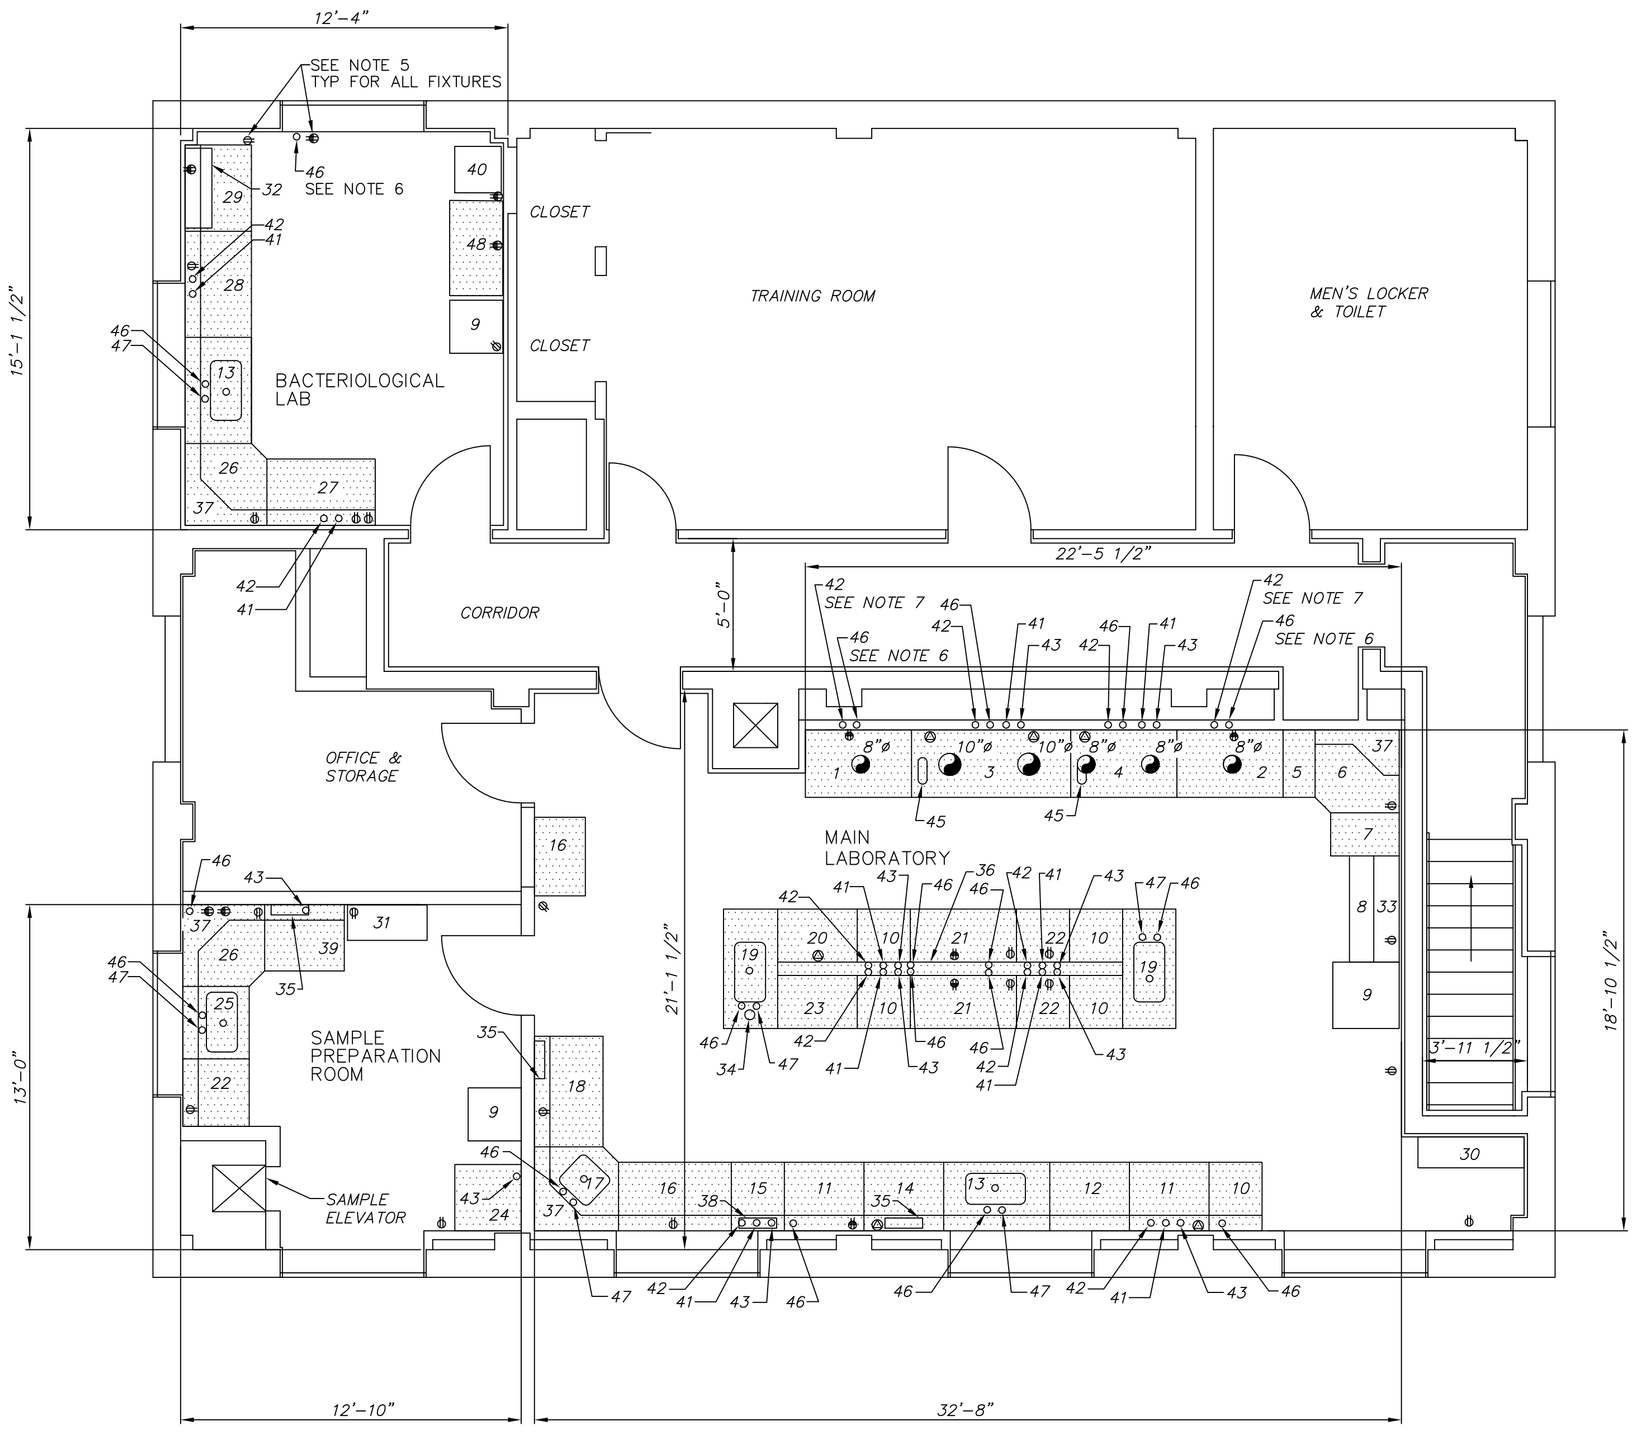


## LABORATORY LEGEND

| ITEM | DESCRIPTION |
|---|---|
| 1. | 1 EA. 4' CANOPY HOOD W/1 EA. 4' DRAWER UNIT & PVC DUCT & CAP |
| 2. | 1 EA. 4' CANOPY HOOD W/1 EA. 4' DRAWER UNIT & PVC DUCT & CAP |
| 3. | 1 EA. 70" FIBERGLASS FUME HOOD W/EXPLOSION PROOF LIGHT & SERVICES ADD AIR<br>1 EA. EXPLOSION PROOF EXHAUST FAN<br>1 EA. SUPPLY FAN<br>1 EA. 3' SUPPORT BASE UNIT<br>1 EA. 3' SUPPORT BASE UNIT TRANSITE LINED<br>1 EA. SPEC TECH TOP WORK TOP<br>1 EA. PVC DUCT W/WEATHER CAP |
| 4. | 1 EA. 47" FIBERGLASS FUME HOOD W/EXPLOSION PROOF LIGHT & SERVICES ADD AIR<br>1 EA. EXPLOSION PROOF EXHAUST FAN<br>1 EA. SUPPLY FAN<br>1 EA. 4' SUPPORT BASE UNIT<br>1 EA. SPEC TECH TOP WORK TOP<br>1 EA. PVC DUCT W/WEATHER CAP |
| 5. | 1 EA. DRAWER UNIT |
| 6. | 1 EA. CORNER CUPBOARD |
| 7. | 1 EA. DRAWER UNIT |
| 8. | 1 EA. BALANCE TABLE |
| 9. | 3 EA. REFRIGERATOR |
| 10. | 5 EA. DRAWER CUPBOARD UNIT |
| 11. | 2 EA. DRAWER UNIT |
| 12. | 1 EA. DRAWER CUPBOARD |
| 13. | 1 EA. SINK BASE UNIT<br>1 EA. DURATEK SINK BASIN<br>1 EA. DOUBLE FAUCET<br>1 EA. VACUUM BREAKER<br>1 EA. PYREX P-TRAP<br>1 EA. PYREX OVERFLOW |
| 14. | 1 EA. DRAWER UNIT |
| 15. | 1 EA. DRAWER UNIT |
| 16. | 2 EA. DRAWER CUPBOARD |
| 17. | 1 EA. SINK BASE UNIT<br>1 EA. DURATEK SINK BASIN<br>1 EA. DOUBLE FAUCET<br>1 EA. VACUUM BREAKER<br>1 EA. PYREX P-TRAP<br>1 EA. PYREX OVERFLOW |
| 18. | 1 EA. CUPBOARD UNIT |
| 19. | 2 EA. SINK BASE UNIT<br>2 EA. DURATEK SINK BASIN<br>2 EA. DOUBLE FAUCET<br>2 EA. VACUUM BREAKER<br>2 EA. PYREX P-TRAP<br>2 EA. PYREX OVERFLOW |
| 20. | 1 EA. DRAWER CUPBOARD |
| 21. | 2 EA. DRAWER UNIT |
| 22. | 3 EA. DRAWER UNIT |
| 23. | 1 EA. DRAWER UNIT |
| 24. | 1 EA. DRAWER CUPBOARD |
| 25. | 1 EA. SINK BASE UNIT<br>1 EA. DURATEK SINK BASIN<br>1 EA. DOUBLE FAUCET<br>1 EA. VACUUM BREAKER<br>1 EA. PYREX P-TRAP<br>1 EA. PYREX OVERFLOW |
| 26. | 2 EA. CORNER CUPBOARD W/ LAZY SUSAN |
| 27. | 1 EA. DRAWER CUPBOARD |
| 28. | 1 EA. DRAWER UNIT |
| 29. | 1 EA. VERSA TABLE W/1 PR. LEGS |
| 30. | 1 EA. FLOOR CASE |
| 31. | 1 EA. FLOOR CASE |
| 32. | 1 EA. WALL CASE |
| 33. | 1 EA. WALL CASE |
| 34. | 1 EA. EYE WASH |
| 35. | 4 EA. PEGBOARD |
| 36. | 1 EA. CENTRAL SERVICE SHELF |
| 37. | 4 EA. CORNER SERVICE SHELF |
| 38. | 7 EA. WALL SERVICE SHELF |
| 39. | 1 EA. DRAWER CUPBOARD |
| 40. | STERILIZER |
| 41. | 10 EA. 1/2" VACUUM OUTLET |
| 42. | 12 EA. 1/2" GAS OUTLET |
| 43. | 10 EA. 1/2" COMPRESSED AIR OUTLET |
| 44. | PVC EXHAUST & SUPPLY DUCTWORK, |
| 45. | SINK |
| 46. | 18 EA. 1/2" COLD WATER OUTLET |
| 47. | 6 EA. 1/2" HOT WATER OUTLET |
| 48. | 1 EA. VERSA TABLE W/ 2 PAIR LEGS |
| 49. | 21 EA. 120 V DUPLEX OUTLET, |
| 50. | 6 EA. 120 V OUTLET, |
| 51. | 11 EA. 240 V OUTLET, |

DEMO NOTES TO CONTRACTOR:

1. ITEMS FOR DEMOLITION .
2. ITEM NO 30 AND 31 TO BE MOVED TO THE TRAINING ROOM FOR USE BY THE CITY.
3. DEMO ALL COUNTER TOPS IN THE MAIN LABORATORY, SAMPLE PREPARATION ROOM, AND BACTERIOLOGICAL LAB.
4. SEE TECHNICAL SECTION 02080, ASBESTOS ABATEMENT ON DISPOSAL PROCEDURES FOR LABORATORY MATERIALS CONTAINING ASBESTOS.
5. DEMO ALL SERVICE FITTINGS AND ELECTRICAL FIXTURES.
6. CAP EXISTING 1/2" COLD WATER LINE.
7. CAP EXISTING 1/2" GAS LINE.
8. DEMO EXISTING 8" AND 10" PVC EXHAUST AND SUPPLY DUCT () CONNECTING THE FUME HOODS AND CANOPY HOODS TO THEIR CORRESPONDING FANS ON THE ROOF.
9. DEMO EXISTING (4) EXHAUST FANS AND (2) SUPPLY FANS LOCATED ON THE ROOF.

THESE RECORD DOCUMENTS HAVE BEEN PREPARED BASED ON INFORMATION PROVIDED BY OTHERS. CTI ENVIRONMENTAL HAS REVIEWED THE INFORMATION SUBMITTED AND BELIEVES IT REFLECTS THE WORK AS CONSTRUCTED. HOWEVER, ALL PERSONS SHALL VERIFY INFORMATION TAKEN FROM THIS DRAWING.

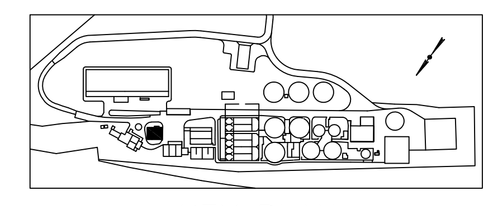

KEY PLAN

THIS DRAWING IS AN INSTRUMENT OF SERVICE OWNED BY CTI ENVIRONMENTAL, INC. WHICH SHALL BE DEEMED THE AUTHOR AND WHICH SHALL RETAIN ALL STATUTORY AND COMMON LAW RIGHTS, INCLUDING COPYRIGHTS. THIS DRAWING WAS PREPARED FOR THE USE OF THE OWNER AND IS NOT TO BE REPRODUCED OR DISTRIBUTED TO OTHERS IN ANY FORM, OR USED FOR ANY OTHER PURPOSE OR PROJECT WITHOUT PRIOR WRITTEN CONSENT OF CTI ENVIRONMENTAL, INC. CTI ENVIRONMENTAL, INC. CANNOT GUARANTEE THAT DUPLICATES OF THE ORIGINAL DRAWING REPRESENT THE SEALED ORIGINAL. IN THE EVENT OF A CONFLICT BETWEEN AN ELECTRONIC COPY AND THE SEALED ORIGINAL, THE SEALED ORIGINAL SHALL GOVERN.

REVISIONS

| NO. | DESCRIPTIONS | DATE | BY | APP'D |
|---|---|---|---|---|
| 1 | RECORD DRAWING | 6/05 | MGW | WAD |

DESIGNED BY PMK
DRAWN BY SAT/AJP
CHECKED BY RWR
APPROVED BY WAD

CTI ENVIRONMENTAL, INC.
ENGINEERS IN WATER AND EARTH SCIENCES
UNIONTOWN, OHIO

CITY OF MASSILLON, OHIO
WWTP UPGRADE 2000
LABORATORY DEMOLITION

JOB NO. E9031
DATE 08/13/01
SCALE 1/4"=1'-0"
SHEET P133

E:/E9031/9031LAB1-2.DWG