


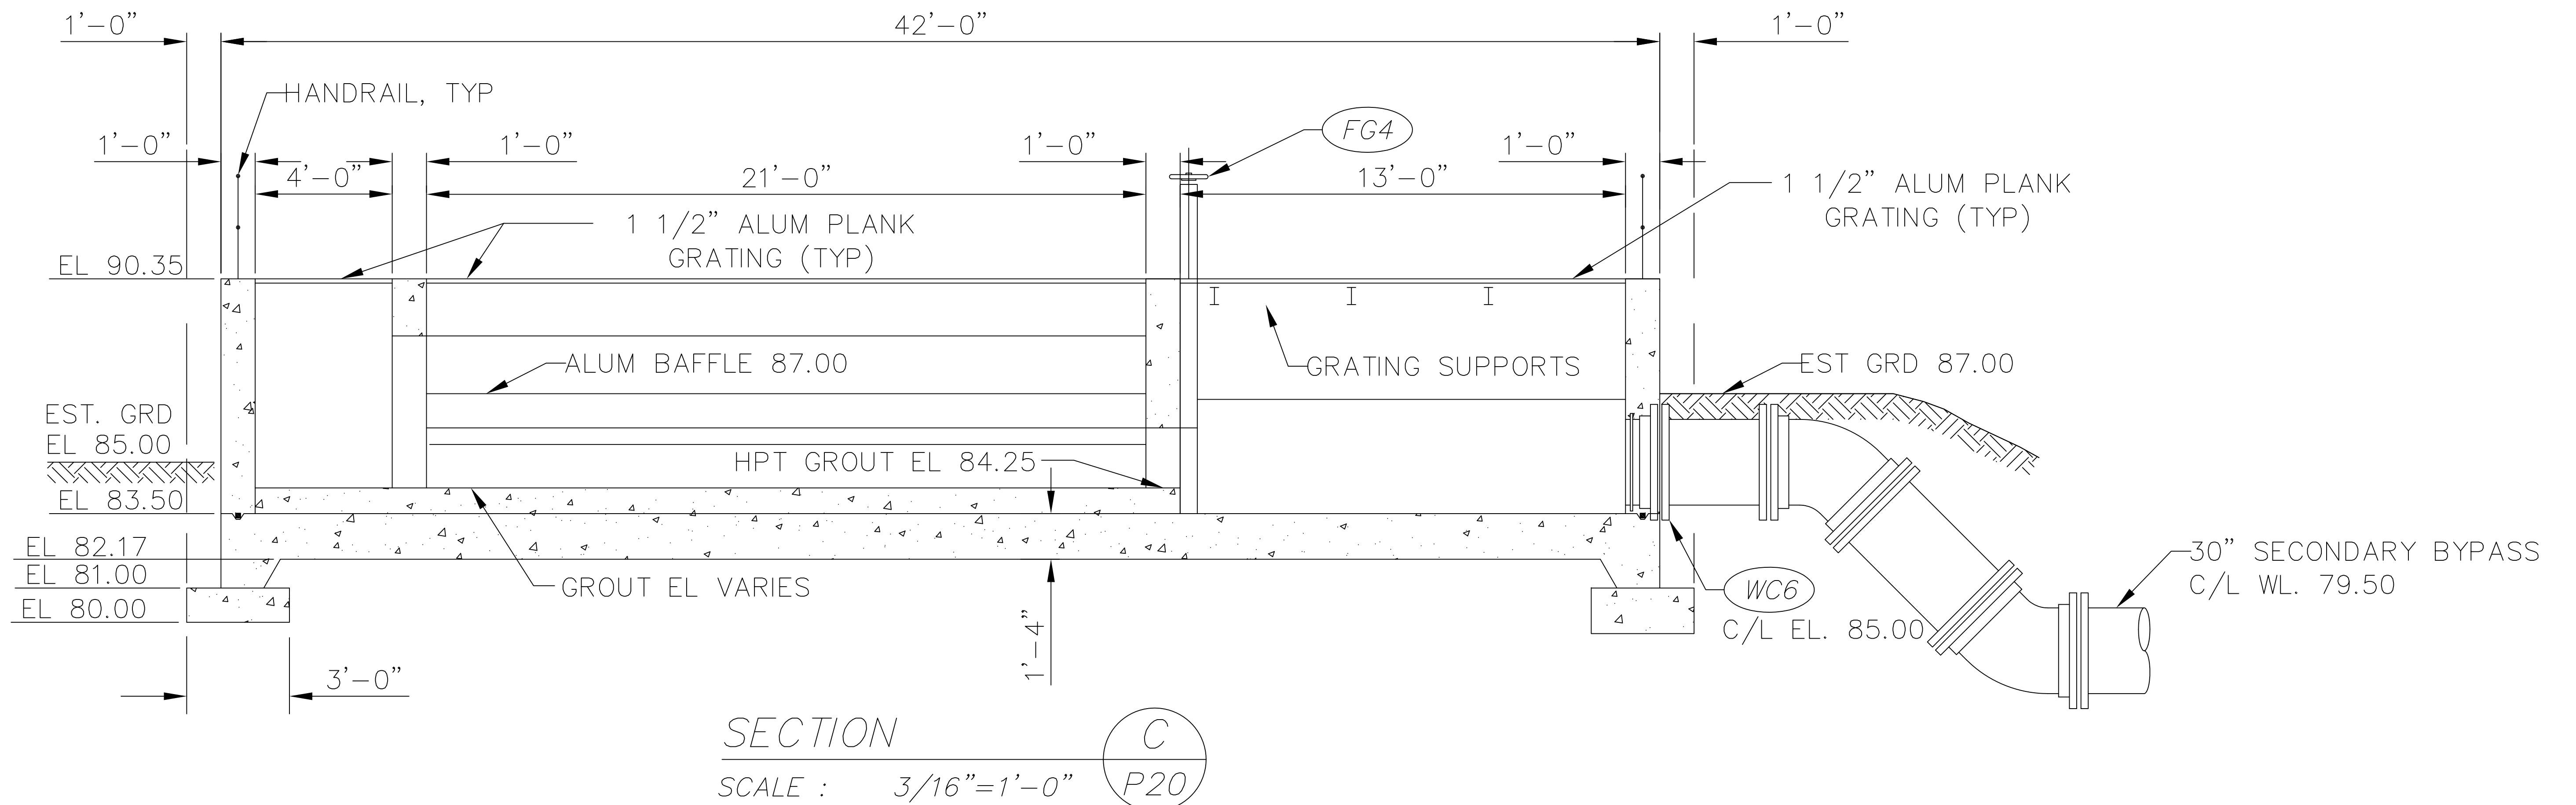

ON P21

ADDENDUM NO. 3

CITY OF MASSILLON, OHIO
WWTP UPGRADE 2000



SK-P21-001