



ON P21

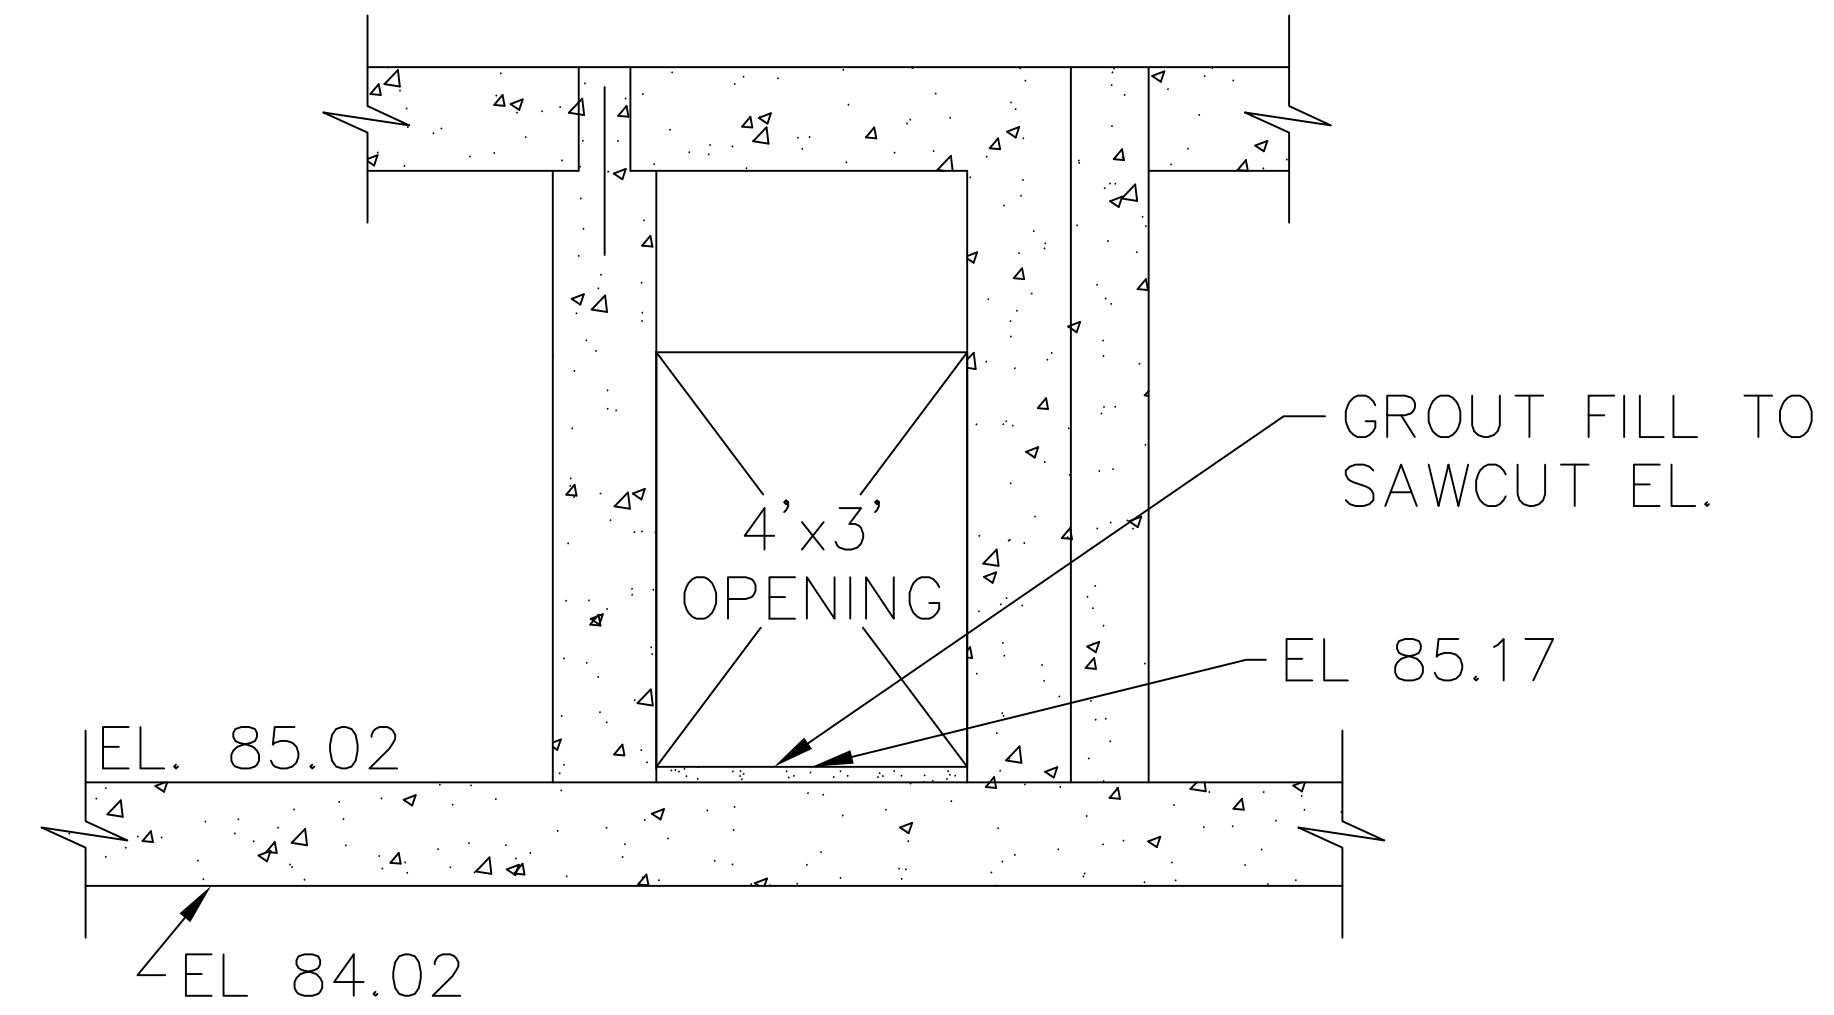

SECTION

SCALE : 1/4"=1'-0"

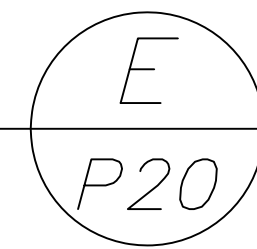

ADDENDUM NO. 3

CITY OF MASSILLON, OHIO
WWTP UPGRADE 2000



SK-P21-003