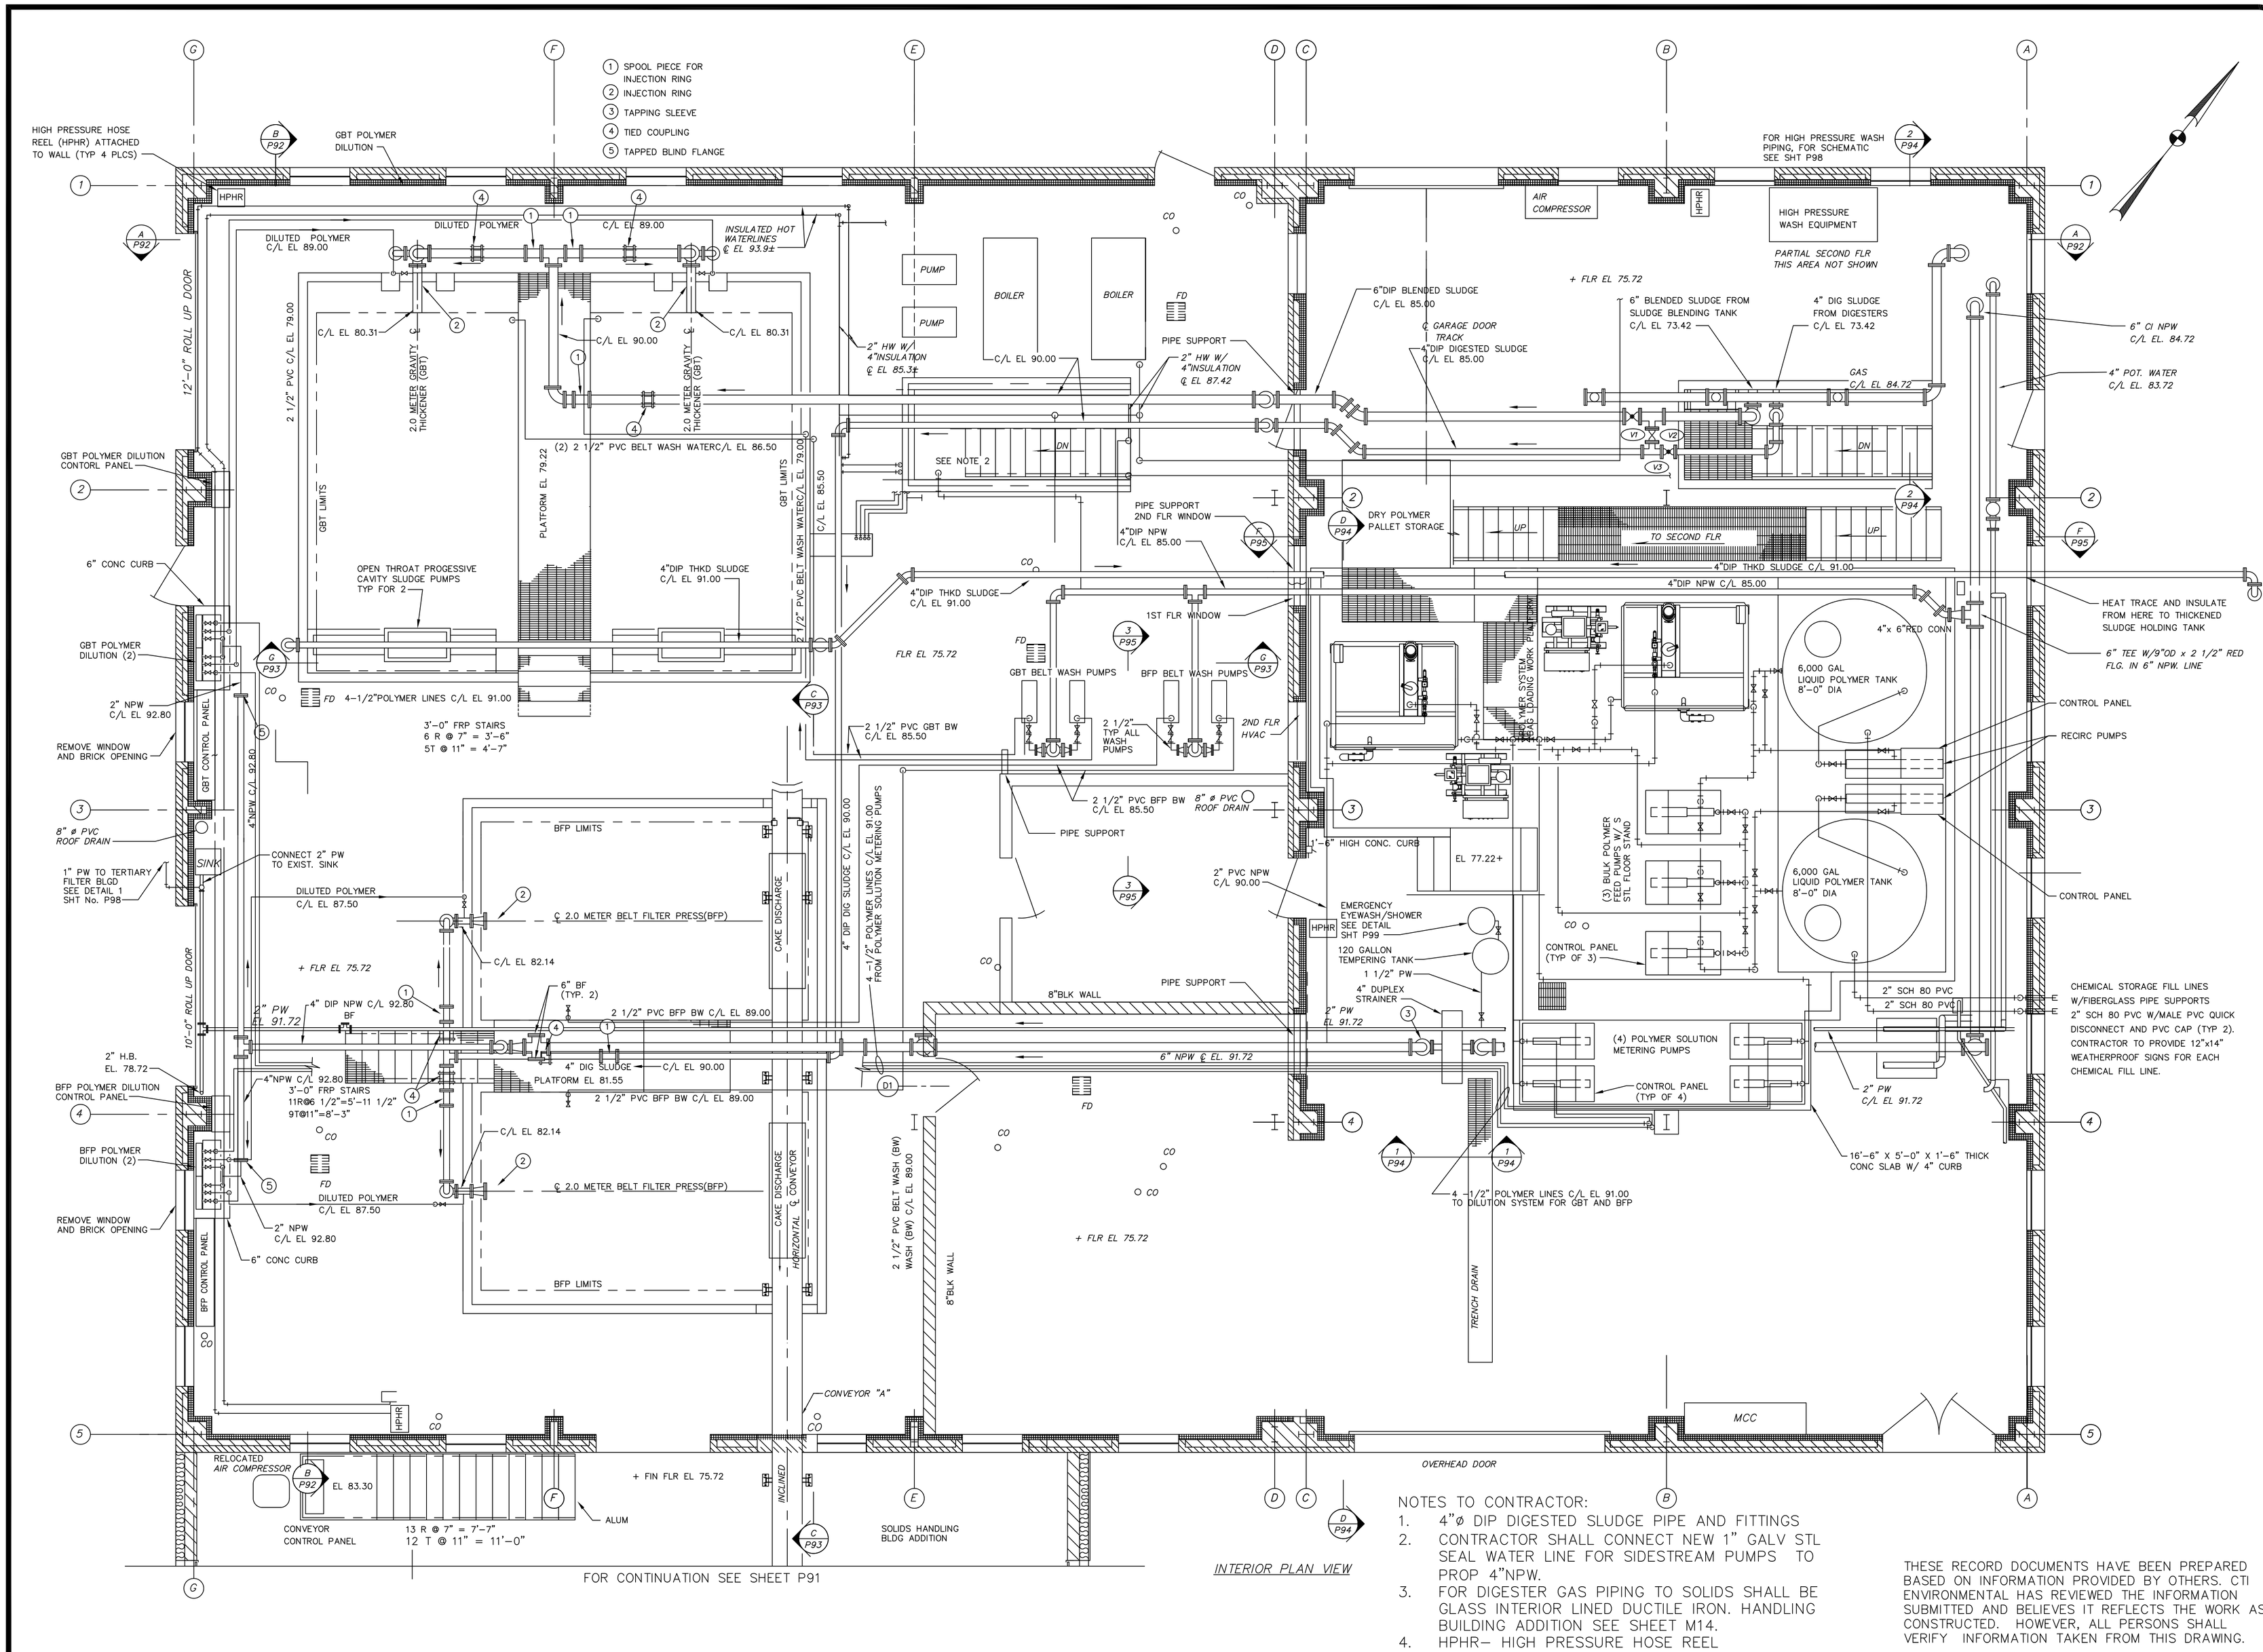

INTERIOR PLAN VIEW

NOTES TO CONTRACTOR:

1. 4"ø DIP DIGESTED SLUDGE PIPE AND FITTINGS
2. CONTRACTOR SHALL CONNECT NEW 1" GALV STL SEAL WATER LINE FOR SIDESTREAM PUMPS TO PROP 4"NPW.
3. FOR DIGESTER GAS PIPING TO SOLIDS SHALL BE GLASS INTERIOR LINED DUCTILE IRON. HANDLING BUILDING ADDITION SEE SHEET M14.
4. HPHR– HIGH PRESSURE HOSE REEL

THESE RECORD DOCUMENTS HAVE BEEN PREPARED BASED ON INFORMATION PROVIDED BY OTHERS. CTI ENVIRONMENTAL HAS REVIEWED THE INFORMATION SUBMITTED AND BELIEVES IT REFLECTS THE WORK AS CONSTRUCTED. HOWEVER, ALL PERSONS SHALL VERIFY INFORMATION TAKEN FROM THIS DRAWING.

THIS DRAWING IS AN INSTRUMENT OF SERVICE OWNED BY CTI ENVIRONMENTAL, INC. WHICH SHALL BE DEEMED THE AUTHOR OF THIS DOCUMENT WITHIN THE STATUTORY AND COMMON LAW RIGHTS, INCLUDING COPYRIGHTS. DISTRIBUTION OF THIS DRAWING IS LIMITED, AND NO REPRODUCTION OR DISTRIBUTION IN ANY FORM MAY BE MADE OR USED FOR ANY OTHER PURPOSE OR PROJECT WITHOUT PRIOR WRITTEN AUTHORIZATION OF CTI ENVIRONMENTAL, INC. CTI ENVIRONMENTAL, INC. CANNOT GUARANTEE THAT ELECTRONIC COPIES OF THIS DRAWING ARE EXACT REPLICATIONS OF THE SEALED ORIGINAL. IN THE EVENT OF A CONFLICT BETWEEN AN ELECTRONIC COPY AND THE SEALED ORIGINAL, THE SEALED ORIGINAL SHALL GOVERN.

REVISIONS

NO.	DESCRIPTIONS	DATE	BY	APP'D
1	ADDENDUM NO. 1	9/14	RWR	WAD
2	RECORD DRAWING	4/05	MCW	WAD

DESIGNED BY AJP/TMK
DRAWN BY AJP
CHECKED BY TMK/RWR
APPROVED BY RWR

CTI ENVIRONMENTAL, INC.
ENGINEERS IN WATER AND EARTH SCIENCES
UNIONTOWN, OHIO

CITY OF MASSILLON, OHIO
WWTP UPGRADE 2000
SOLIDS HANDLING FACILITIES – PLAN

JOB NO. E9031
DATE 08/13/01
SCALE 1/4"=1'-0"
SHEET P89

E: /E9031/9031SHF6.DWG